

# PUBLIC WORKS REPORT

August 13, 2009

## STREETS:

**Sultan Basin Road** Phase III, Moving ahead with Stage 1 of the project. Stage 1 is the portion recently renamed South Basin Road (Foundry Drive). Additional funds have been obligated with Washington Dept. of Washington to complete design and right of way purchase. Certified Land has been negotiating with the property owner for purchase of property and relocation of the renters.

**US 2 and Rice Rd.** required landscape for the Sno-Country Building adjacent to the state right of way, was brought to the council by the neighboring business owner with the complaint the trees are blocking the site distance for his business. In working with business owners within Sultan, staff will be pruning the trees up and back to increase the site distance for Mt. View Chevron.

**Block Watch signs** were purchased by the city (10) and the community grant (10) received for graffiti removal, safety and improvement funds.

24" X 36" signs will be posted at the west and east city limits on US 2 and on 311<sup>th</sup> Street SE between the bridge and BNSF Railroad Tracks.

The first ten "Neighborhood Crime Watch" signs (18" X 24") will be placed as follows: (Attachment A)

1. Just north of Main Street at 1<sup>st</sup>, 2<sup>nd</sup>, 3<sup>rd</sup>, 4<sup>th</sup>, 5<sup>th</sup>, 6<sup>th</sup>, and 8<sup>th</sup> east side of the street.
2. Westside of South Sultan Basin Road (Foundry Dr.) 100 Block
3. Eastside of Sultan Basin Road north of US 2
4. Westside of 10<sup>th</sup> south of US 2

At the Block Watch meeting on August 19<sup>th</sup> the second 10 signs will be offered to Block Watch captains' areas.

**Left Turn Lane** southbound on Rice Road: When Mc Donald's was built in 2000 the design on US 2 was a right hand deceleration with a merge lane on Rice Rd. that was the requirement by the City and WSDOT (Attachment B).

## BUILDING:

The **facility assessment** by Driftmier Architects was started July 24<sup>th</sup> some additional information will be gathered August 7, 2009. The report will be available to the City by October, 2009.


## PARKS:

A bear cub (approx 200 lbs) has been seen on First Street in the Osprey Park area. Washington Fish and Wild Life (WFWL) recommended posting of the park, which has been completed. WFWL recommends citizens keep all garbage and food secured. Sultan has many fruit trees, especially apple; the owners need to keep all fruit that falls to the ground picked up daily. Bears are like humans they go to the food. If you use the City


Parks, **pack out all your garbage** and encourage others to do the same. Public Works posted both Osprey and Reese Parks (Attachment C). WFWL telephone number is 425-775-1311

**Osprey Park Clean up:** The Public Works Crew members have been on the trails cutting brush, pulling damaged benches and interpretative signs out then filling in the holes.

**STAFF:**

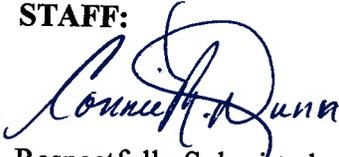
A handwritten signature in blue ink that reads "Connie Dunn". The signature is stylized with a large, looping initial "C" and "D".

Respectfully Submitted  
Connie Dunn  
Public Works Director  
Chose to enjoy your day

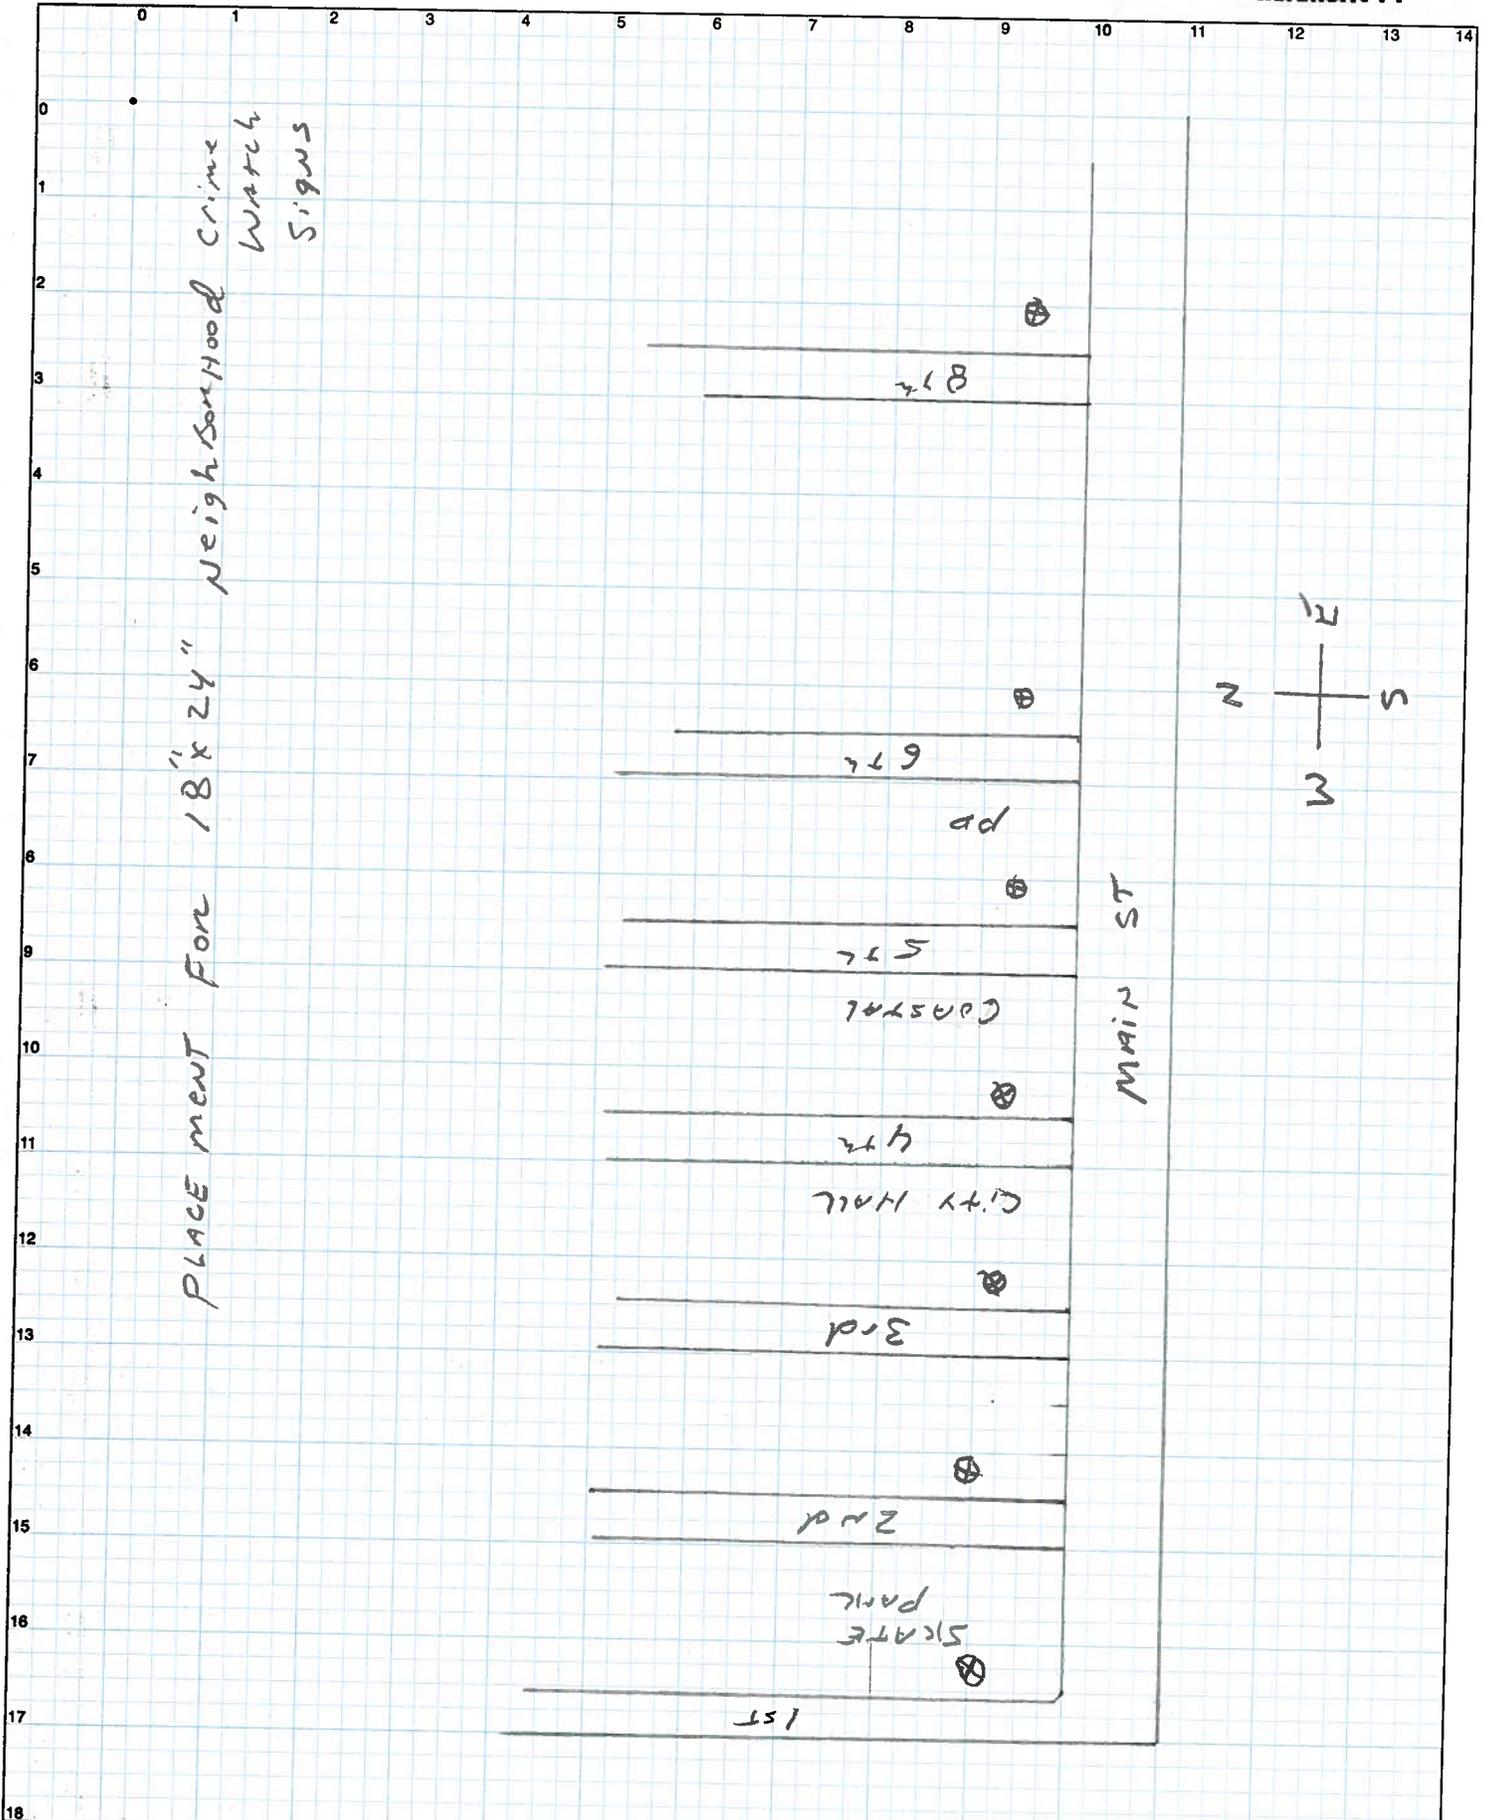


PLACE MENT FOR 18" X 24" NEIGHBORHOOD CRIME WATCH SIGNS

MAIN ST

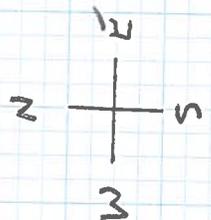

<b>HUNTWOOD</b> CUSTOM CABINETS	DESCRIPTION	SCALE: 1/2" = 10'
	23800 E. Appleway, Liberty Lake, WA 99019 (509) 924-5858 • (800) 873-7980	DESIGNER
		DATE REVISED

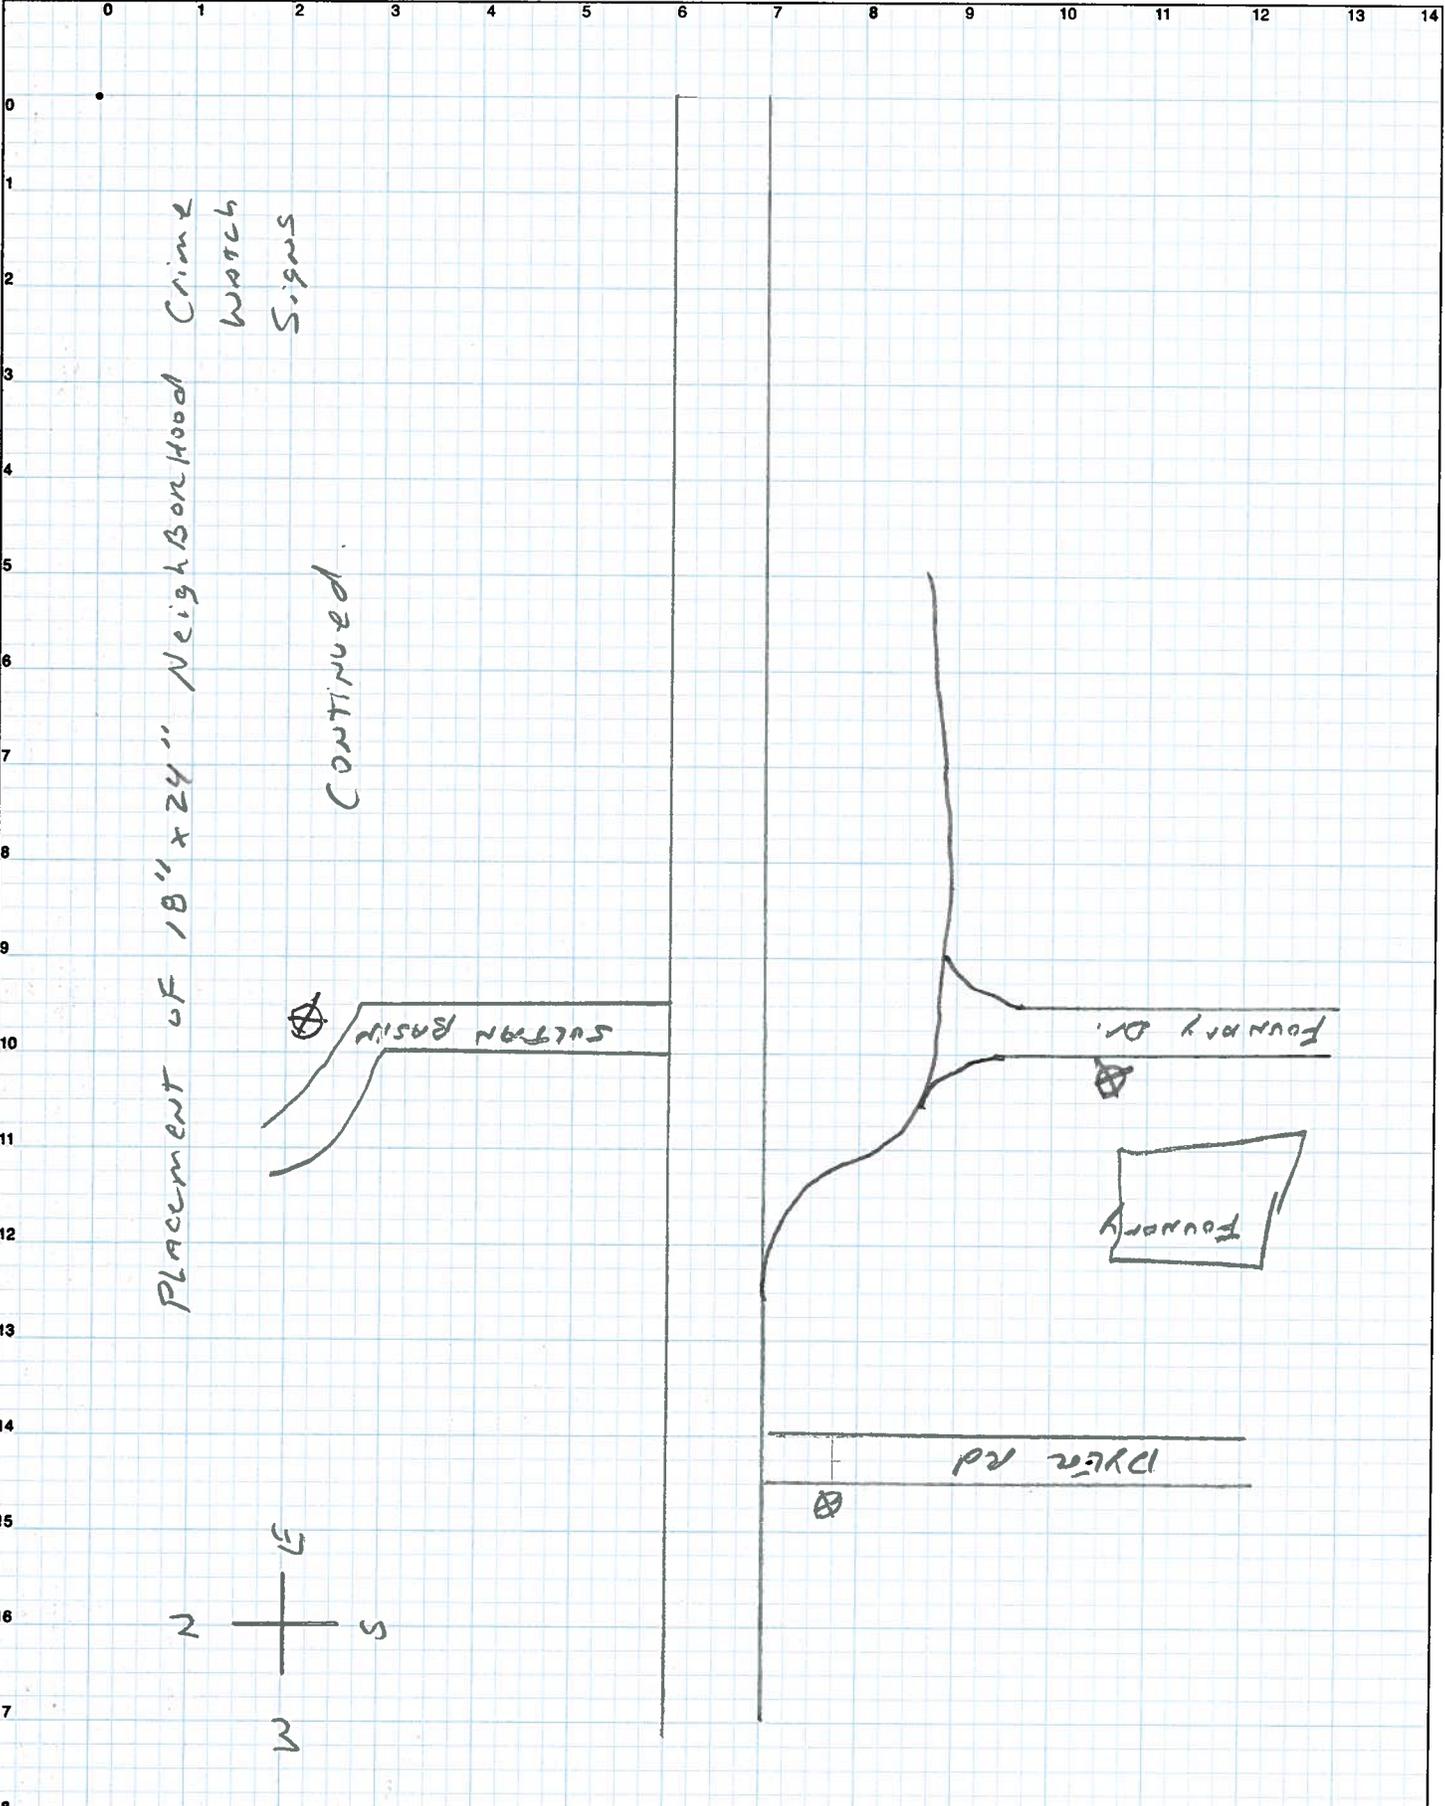

<b>HUNTWOOD</b> CUSTOM CABINETS	DESCRIPTION 23800 E. Appleway, Liberty Lake, WA 99019 (509) 924-5858 • (800) 873-7960	DESIGNER	SCALE: 1/2" = 10'
	DATE	DATE REVISION	DATE REVISION

OLD OWEN RD.



WEST CITY LIMIT  
BUT EAST OF  
OLD OWEN

311th BRIDGE


S R 2

Placement for welcome to Sultan  
Crime Watch Signs 24" x 36"  
3 LOCATIONS

EAST  
CITY LIMIT

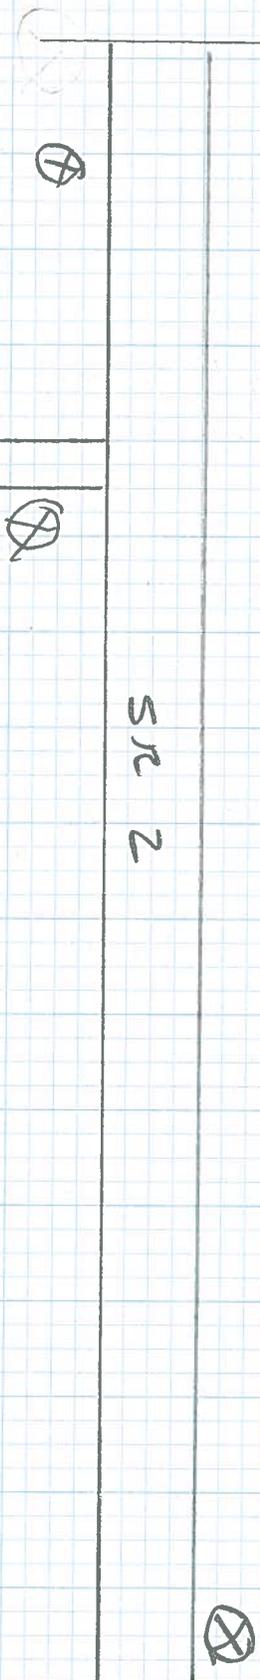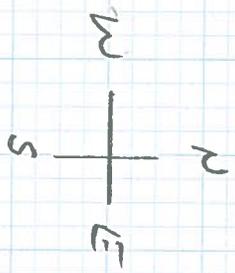

1"=20'

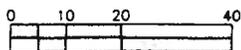

# !! ATTENTION !!



A BEAR



HAS BEEN SEEN IN  
THIS PARK.

Please pack out all garbage from the park and make sure if you have fruit trees on your property, to clean up any fallen fruit.

The Department of Fish and Wildlife responds to bear sightings when there is a threat to public safety or property. If it is an emergency, dial 911.

If you encounter a black bear problem, and it is not an emergency, contact the nearest Regional Department of Fish and Wildlife Office between the hours of 8 a.m. and 5 p.m., Monday through Friday at (425)775-1311.